


CAUFFIEL HOUSE
AS BUILT
FIRST FLOOR PLAN



DESIGNED BY:	T.C.R.S.S.
DRAWN BY:	T.C.R.S.S.
DATE:	08/31/93
APPROVED BY:	T.C.R.S.S.
BUILDING NO.:	33-001
SCALE:	1/4" = 1'-0"
DRAWING NO.:	
SHEET NO.:	A-2 OF 4

DATE:	REVISION DESCRIPTION:	BY:

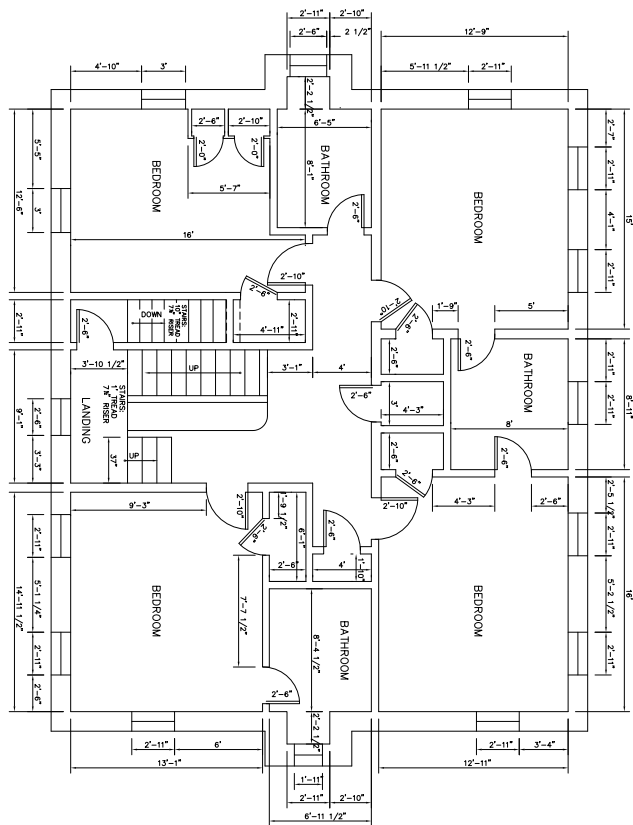


DATE:	REVISION DESCRIPTION:	BY:

CAUFFIEL HOUSE
AS BUILT
SECOND FLOOR PLAN




DESIGNED BY: T.C.R.S.S.
 DRAWN BY: T.C.R.S.S.
 DATE: 08/31/93
 APPROVED BY: T.C.R.S.S.
 BUILDING NO.: 33-001
 SCALE: 1/4" = 1'-0"
 DRAWING NO.:
 SHEET NO.: A-3 OF 4

33-033-001-AFP-403-0993

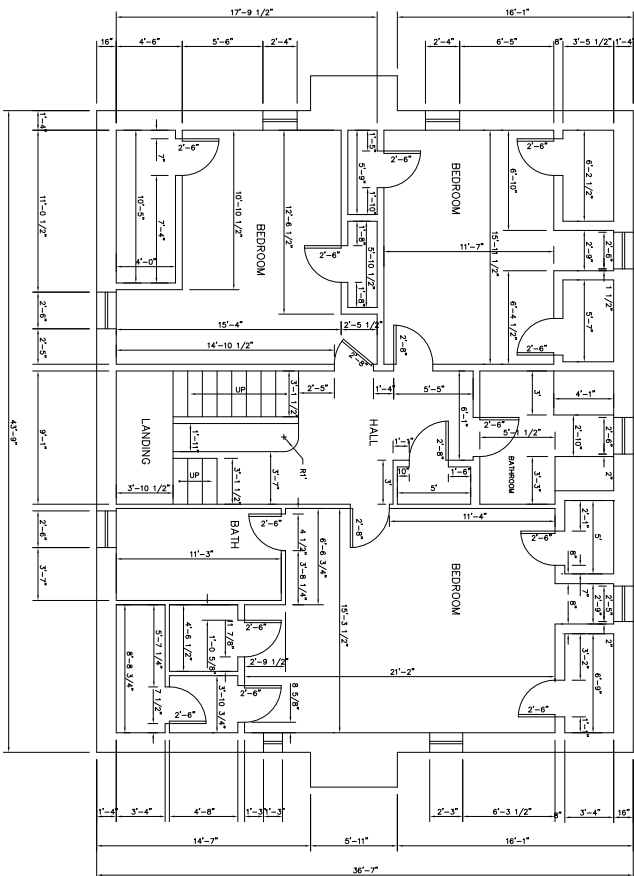

CAUFFIEL HOUSE
AS BUILT
THIRD FLOOR PLAN

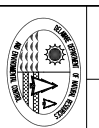

DESIGNED BY: T.C.R.S.S.
 DRAWN BY: T.C.R.S.S.
 DATE: 08/31/93
 APPROVED BY: T.C.R.S.S.
 BUILDING NO.: 33-001
 SCALE: 1/4" = 1'-0"
 DRAWING NO.: SHEET NO.:
 A-4 OF 4

DATE:	REVISION DESCRIPTION:	BY: