

Date: March 26, 2018

Addendum No. 3

Project: Caesar Rodney High School

Sitework and Athletic Fields

Contract N. SRS-18003-CRHSsitework

The work herein shall be considered part of the bid documents for the referenced project and carried out in accordance with the following supplemental instructions issued in accordance with the Contract Documents without change in Contract Sum or Contract Time. Acknowledge receipt of addendum on the bid form as indicated.

### **RFI Responses**

 Question: The foundation plan shows a spread footing every 6'. With the concrete footing design you show they would only need to be on an 18' grid.

**Answer:** The structural system, including the foundation, for New Bleacher Type 2 shown on sheet A3.1 shall be design-build by the bleacher contractor.

## **Changes to Drawings**

A2.0 – SITE DEMOLITION PLAN
 Revised scope / area of work for Site Demolition Key Note SD-12.
 See attached sketch SK-A.04.

2. A3.0 - SITE PLAN

Expanded scope / area of work for detail reference 5/A3.3. Added detail reference 4/A3.3, 1/A3.4, 2/A3.4, 1/A3.5, 2/A3.5 and 1/A3.6. See attached sketches SK-A.05 and SK-A.06.

3. A3.1 – BLEACHER PLANS, SECTIONS AND DETAILS

Revise BLEACHER SCHEDULE to include detail reference numbers for the main stadium home side bleacher and the main stadium visitor side bleacher as indicated below.

BLE	ACHE	R SCHE	DULE
LOCATION	QTY	TYPE	NOTES
BASEBALL	2	TYPE-1	
SOFTBALL	1	TYPE-1	
AUX, STAD <b>I</b> UM	1	TYPE-2	
MAIN HOME SIDE	N/A	EXIST.	MODIFY. SEE 1&2/A3.4.
MAIN VISITOR SIDE	N/A	EXIST.	FENCE ONLY. SEE 1/A3.1.

4. A3.3 – ENLARGED SITE PLANS AND DETAILS

Revise 4/A3.3 STORAGE ROOM – SITE DEMOLITION PLAN to expand area of sidewalk to be demolished.

See attached sketch SK-A.01.



5. A3.3 - ENLARGED SITE PLANS AND DETAILS

Revise 5/A3.3 STORAGE ROOM – SITE CONSTRUCTION PLAN to expand area of new concrete sidewalk.

See attached sketch SK-A.02.

6. A3.4 - ENLARGED SITE PLANS AND DETAILS

Revise 2/A3.4 MAIN STADIUM BLEACHER MODIFICATION – CONSTRUCTION PLAN to indicate turndown slab at edge of concrete slab at retaining wall condition.

See attached sketch SK-A.03.

7. A3.5 – WALKWAY PLAN AND DETAILS

Added details 6, 7, 8, 9 and 10. Revised CONSTRUCTION KEY NOTE LEGEND. Added dimensions and notes at plan 1 and plan 2. See attached revised drawing A3.5.

8. A3.6 - LANDSCAPE PLAN AND DETAILS

Added sheet A3.6.

See attached drawing A3.6.

9. E9.3 – ELECTRICAL SINGLE LINE DIAGRAM AND PANEL SCHEDULES Add detail 2/E9.3 ELECTRICAL SITE PLAN – STORAGE BUILDING to show power to grinder pump.

See attached sketch SK-E.01.

E9.3 – ELECTRICAL SINGLE LINE DIAGRAM AND PANEL SCHEDULES
 Revise NEW PANEL PL1S to show power to grinder pump.
 See attached sketch SK-E.01.

### **Changes to Specifications**


11. 13 12 50 – ALUMINUM BLEACHERS

Revise paragraph 2.1 MANUFACTURERS to include Southern Bleacher Company, Inc. as an acceptable manufacturer.

12. 13 26 14 - PERMANENT GRANDSTANDS

Revise paragraph 2.1 MANUFACTURERS to include Southern Bleacher Company, Inc. as an acceptable manufacturer.

End

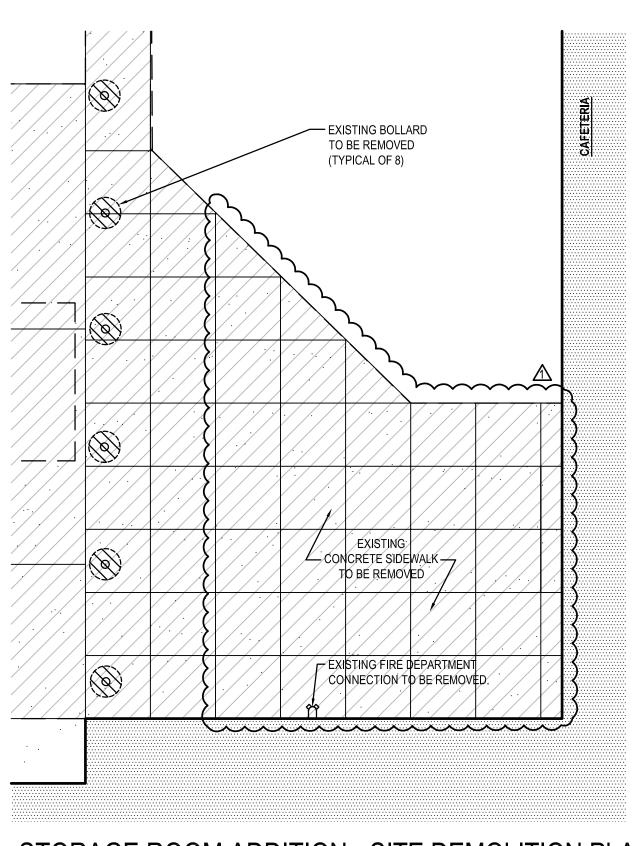



SCALE: 1/8" = 1'-0"


03/26/18 A3.3 SHEET NO. 16061 SK-A.01

PROJECT NO.

CAESAR RODNEY SCHOOL DISTRICT CAESAR RODNEY HIGH SCHOOL ATHLETIC FIELDS AND SITE CONSTRUCTION 239 OLD NORTH ROAD CAMDEN, DE 19934





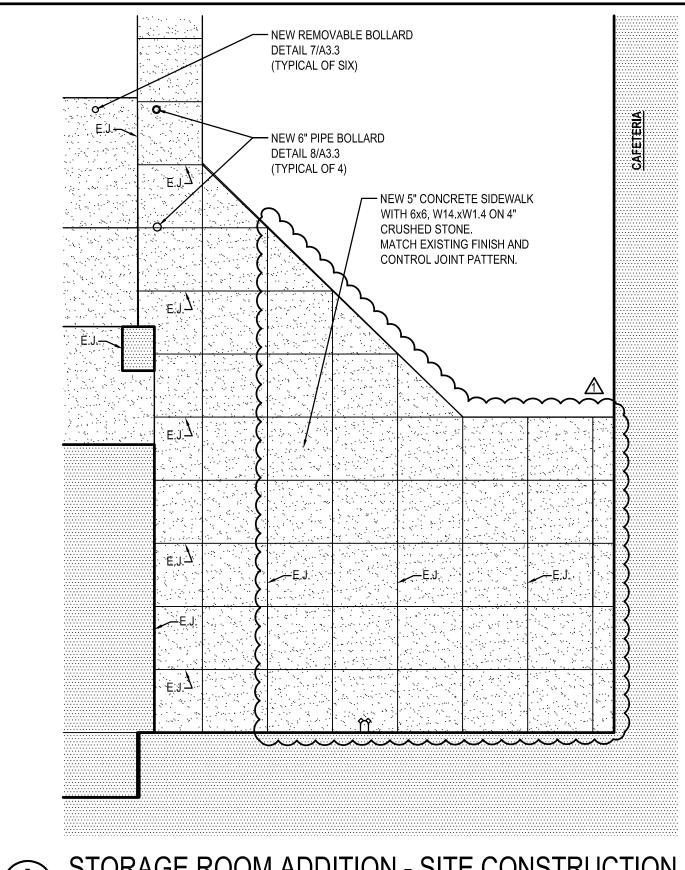



SCALE: 1/8" = 1'-0"

03/26/18 A3.3 SHEET NO.

SK-A 02

3.3

16061

PROJECT NO.

CAESAR RODNEY SCHOOL DISTRICT

CAESAR RODNEY HIGH SCHOOL


ATHLETIC FIELDS AND SITE CONSTRUCTION


239 OLD NORTH ROAD


CAMDEN, DE 19934






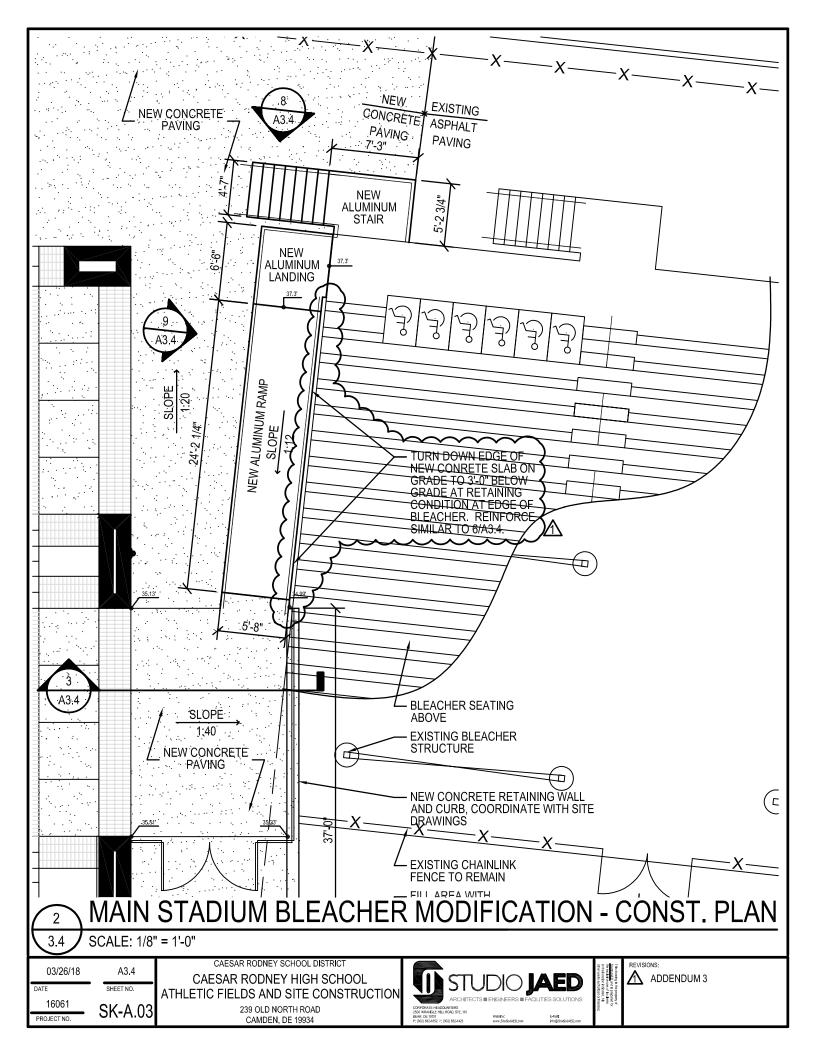

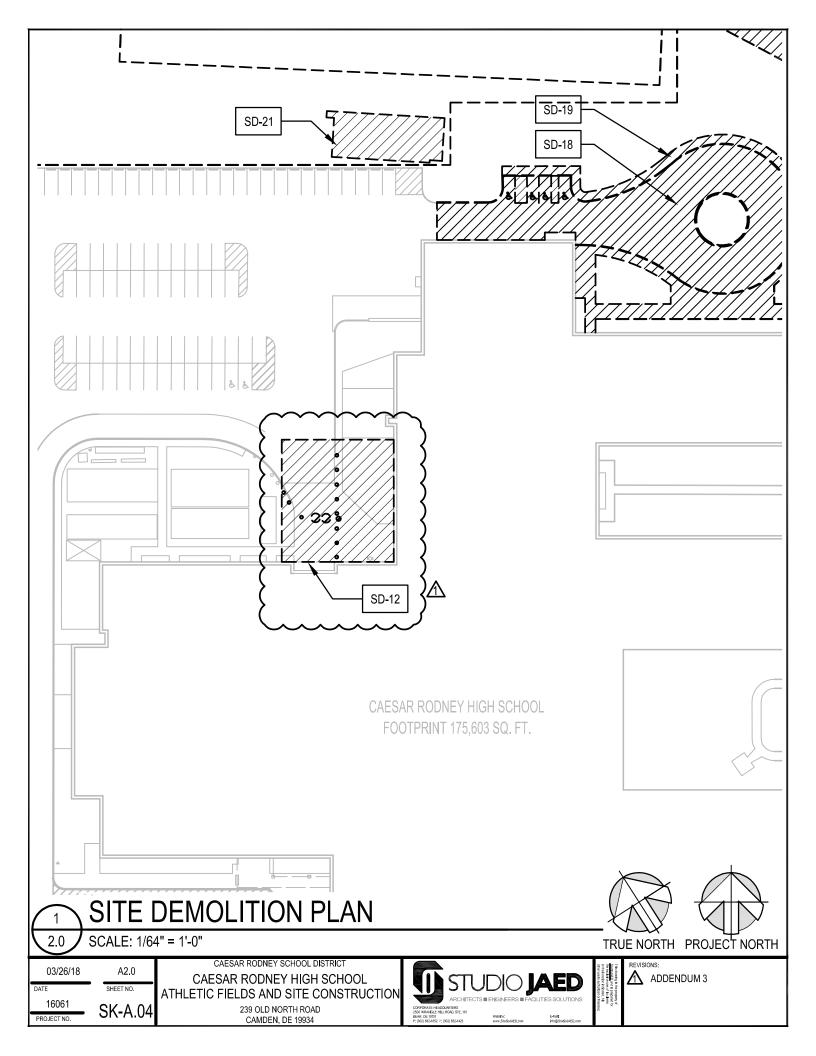

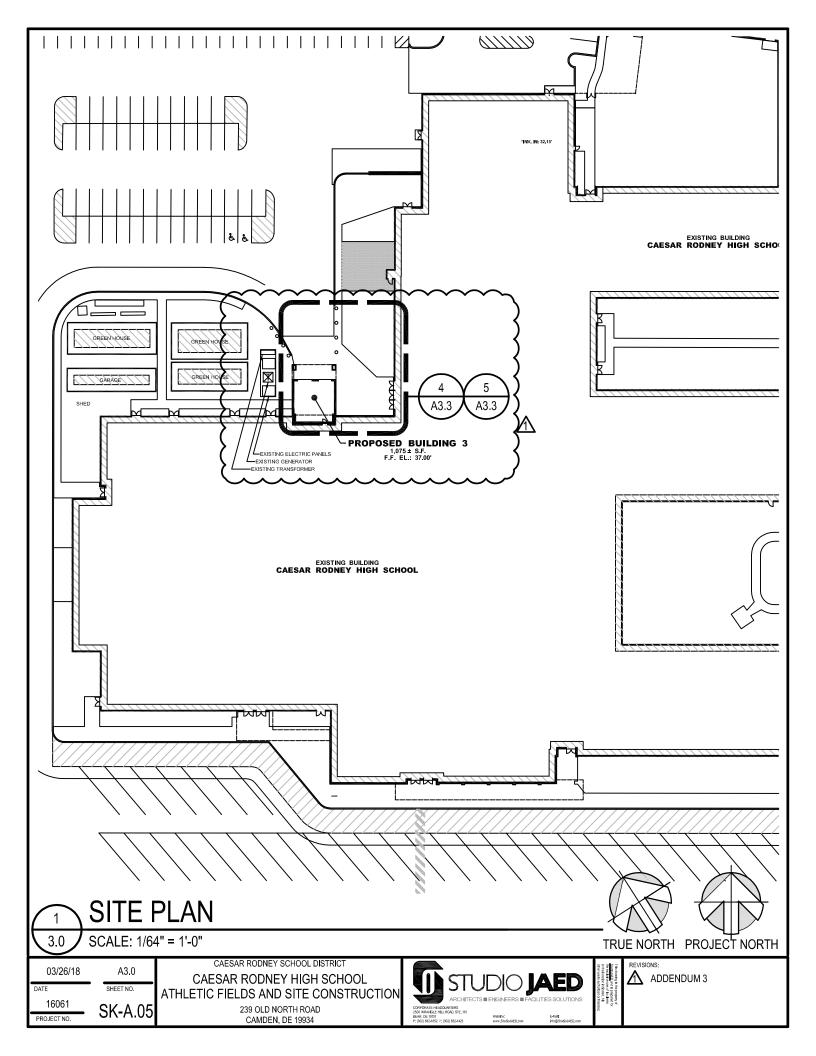

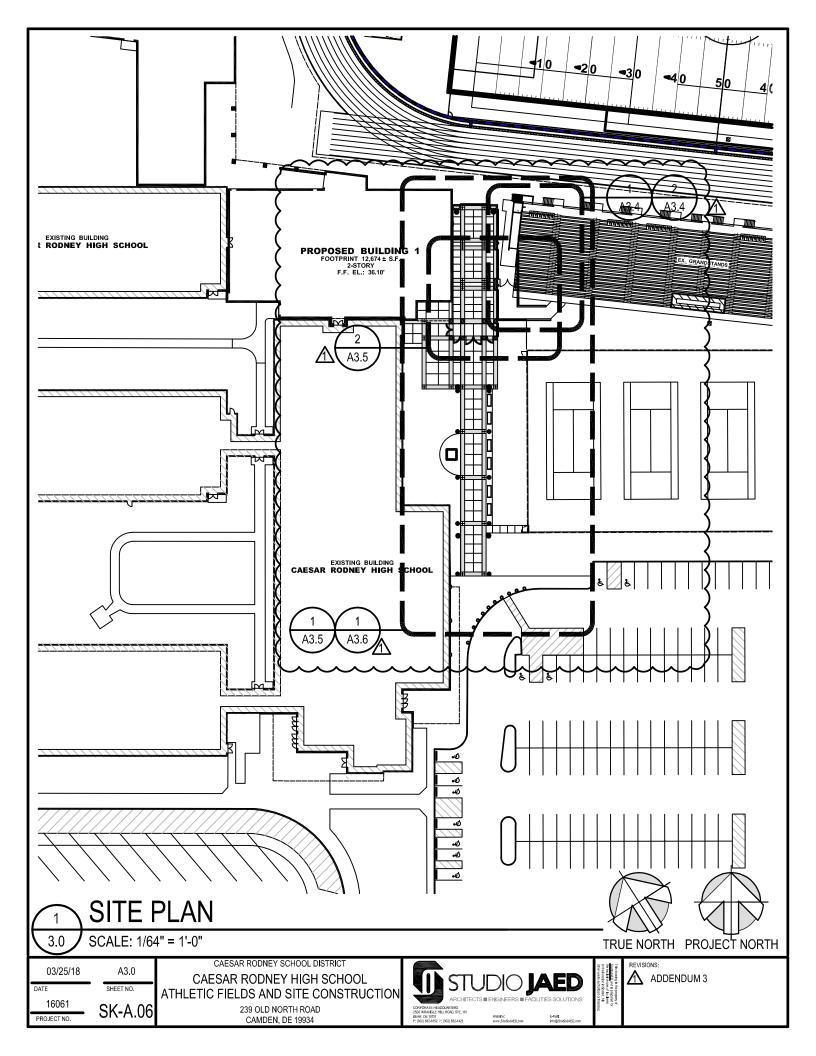

# E9.3 SCALE: 1/16" = 1'-0" ELECTRICAL SITE PLAN - STORAGE BUILDING (N) STARTER - NEMA SIZE 1 IN A NEMA3R UNISTRUT RACK **ENCLOSURE ON A** CONDUIT UNDERGROUND - SEE PANEL SCHEDULE FOR WIRE AND CONDUIT SIZES. STORAGE BUILDING (N) PNL-PH1S (N) LFMC (N) NEMA3R SPLICE BOXES FOR POWER AND CONTROL WIRING. (N) PNL-PL1S SANITARY SEWER GRINDER PUMP STATION - PL1S-40/42 3/26/2018 E9.3 CAESAR RODNEY SCHOOL DISTRICT ADDENDUM #1

16061 SK-E.01

PROJECT NO.

CAESAR RODNEY HIGH SCHOOL ATHLETIC FIELDS AND SITE CONSTRUCTION 239 OLD NORTH ROAD CAMDEN, DE 19934





# **NEW PANEL - PART OF ADDITIONS AND RENOVATIONS PROJECT**

$\bigcap$		*	*			_																		
* **	CONNECTED LOAD PHASE A: kVA PHASE B: kVA PHASE C: kVA TOTAL CONNECTED	8	8			٠		٠			-	٠	•	٠	•	•		٠	٠	•		٠	WIRE	PANEL: LOCATION: BUS: MAIN:
ROVID	CTED B:k C:k		1			٠		٠	•		-		•		٠	1	1	٠		1	1	1	KVA A	<u> </u>
	LOAD VA VA ECTEL	-	0.46				1						ı		1	ı	ı	ı		,	ı	ı	K√A B	7.7
V 20A/	LOAL	0.18				•					٠		ı	٠	•	ı	1		ı	•		1	K ⊗C	STC 225 150
TE CIRCUIT BREA	CONNECTED LOAD PHASE A: KVA PHASE B: KVA PHASE C: KVA PHASE C: KVA	RECEPT - FOOTB	FOOTBALL FIELD SCOREBOARD	1	•	1	1	ı	-	ı	-	-	-	1	-	-	1	'	1	ı	1	1		STORAGE SHED 225A 150A MCB
PROVIDE NEW 20A/1P CIRCUIT BREAKER AND 2#8 + 1#8G-1" WIRING PROVIDE NEW 20A/2P CIRCUIT BREAKER AND 2#10 + 1#10G - 34°C W		RECEPT FOOTBALL SCOREBOARD	SCOREBOARD																				DESCRIPTION	
* PROVIDE NEW 20A/1P CIRCUIT BREAKER AND 2#8 + 1#8G - 1" WIRING. ** PROVIDE NEW 20A/2P CIRCUIT BREAKER AND 2#10 + 1#10G - 3/4"C WIRING FOR POWER + 3#12 + 1#12G - 3/4"C WIRING FOR CONTROLS		1 20	1 20	1	-	1	1		-	1			-			-	1	1	1	-	1	1	Pole Br	
Ř PO		$\rightarrow$	_	37		33	<u>ω</u>	29	27	25	23	21	19	17	15	13	1	9	7	5	ω		욧	
, PR <b>)</b>	. (	$\overline{2}$	7	$\stackrel{?}{\lambda}$	7	7	5	$\supset$	$\Box$	5	$\supset$	7	7	7	7	7	7	7	5	7	$\frac{1}{2}$	\ } 	>	
3#12+	·	+	╁	✐	+	╁	+	+	+	+	+	╁	+	+	┿	+	+	╁	+	+	┿	┥╸	· Ø	
1#120			2	2	,	,	<u>'</u>	2	-		\ <u>\</u>	2	2	7		2	2	2	2	•		75		
3-3/4	}	-	40 20	<del>3</del>	36 -	34	32 -	30 -	28	26	24 -	22 -	20 -	18 -	16 -	14 -	12 -	<del>-</del>	8 -	6	4	2 -	Ckt Br	
	}	$\vdash$	2	1		-		-					-			•	1					,	Pole	
ING FOR CONTROLS	}		GRINDER PUMP	<b>\}</b>	-	•	1	=	-	1	-	-	-	=	=	-	•	1	1	-	1	•		
	<b>\}</b>			}																			DESCRIPTION	VOLTAGE: ENCLOSURE: A.I.C: RATINGS:
	<b>\</b>			<b>\</b>																			K 8	208/120V, 3PH/4W NEMA 1 14,000 FULL
	}	H	0	4		-		-	•			-	-	•	-		1	-	1	1	1	1	KVA K	, 3PH/.
	\		0.92	<del>{</del>		_	-		_	-	_	_	_	-	_	_				•			ØB ØC	4W
	\	0.92	1	X	-	_	-	_	-	_	-	-	-	-	_	_	'	_			-	_		
	}	10	10 **	2	•	٠	•	•	•		٠	٠	1	٠	1		1	1	1	1	•	1	WIRE SIZE	

3/26/2018 E9.3

DATE SHEET NO.


16061 SK-E.02


CAESAR RODNEY SCHOOL DISTRICT
CAESAR RODNEY HIGH SCHOOL
ATHLETIC FIELDS AND SITE CONSTRUCTION
239 OLD NORTH ROAD
CAMDEN, DE 19934







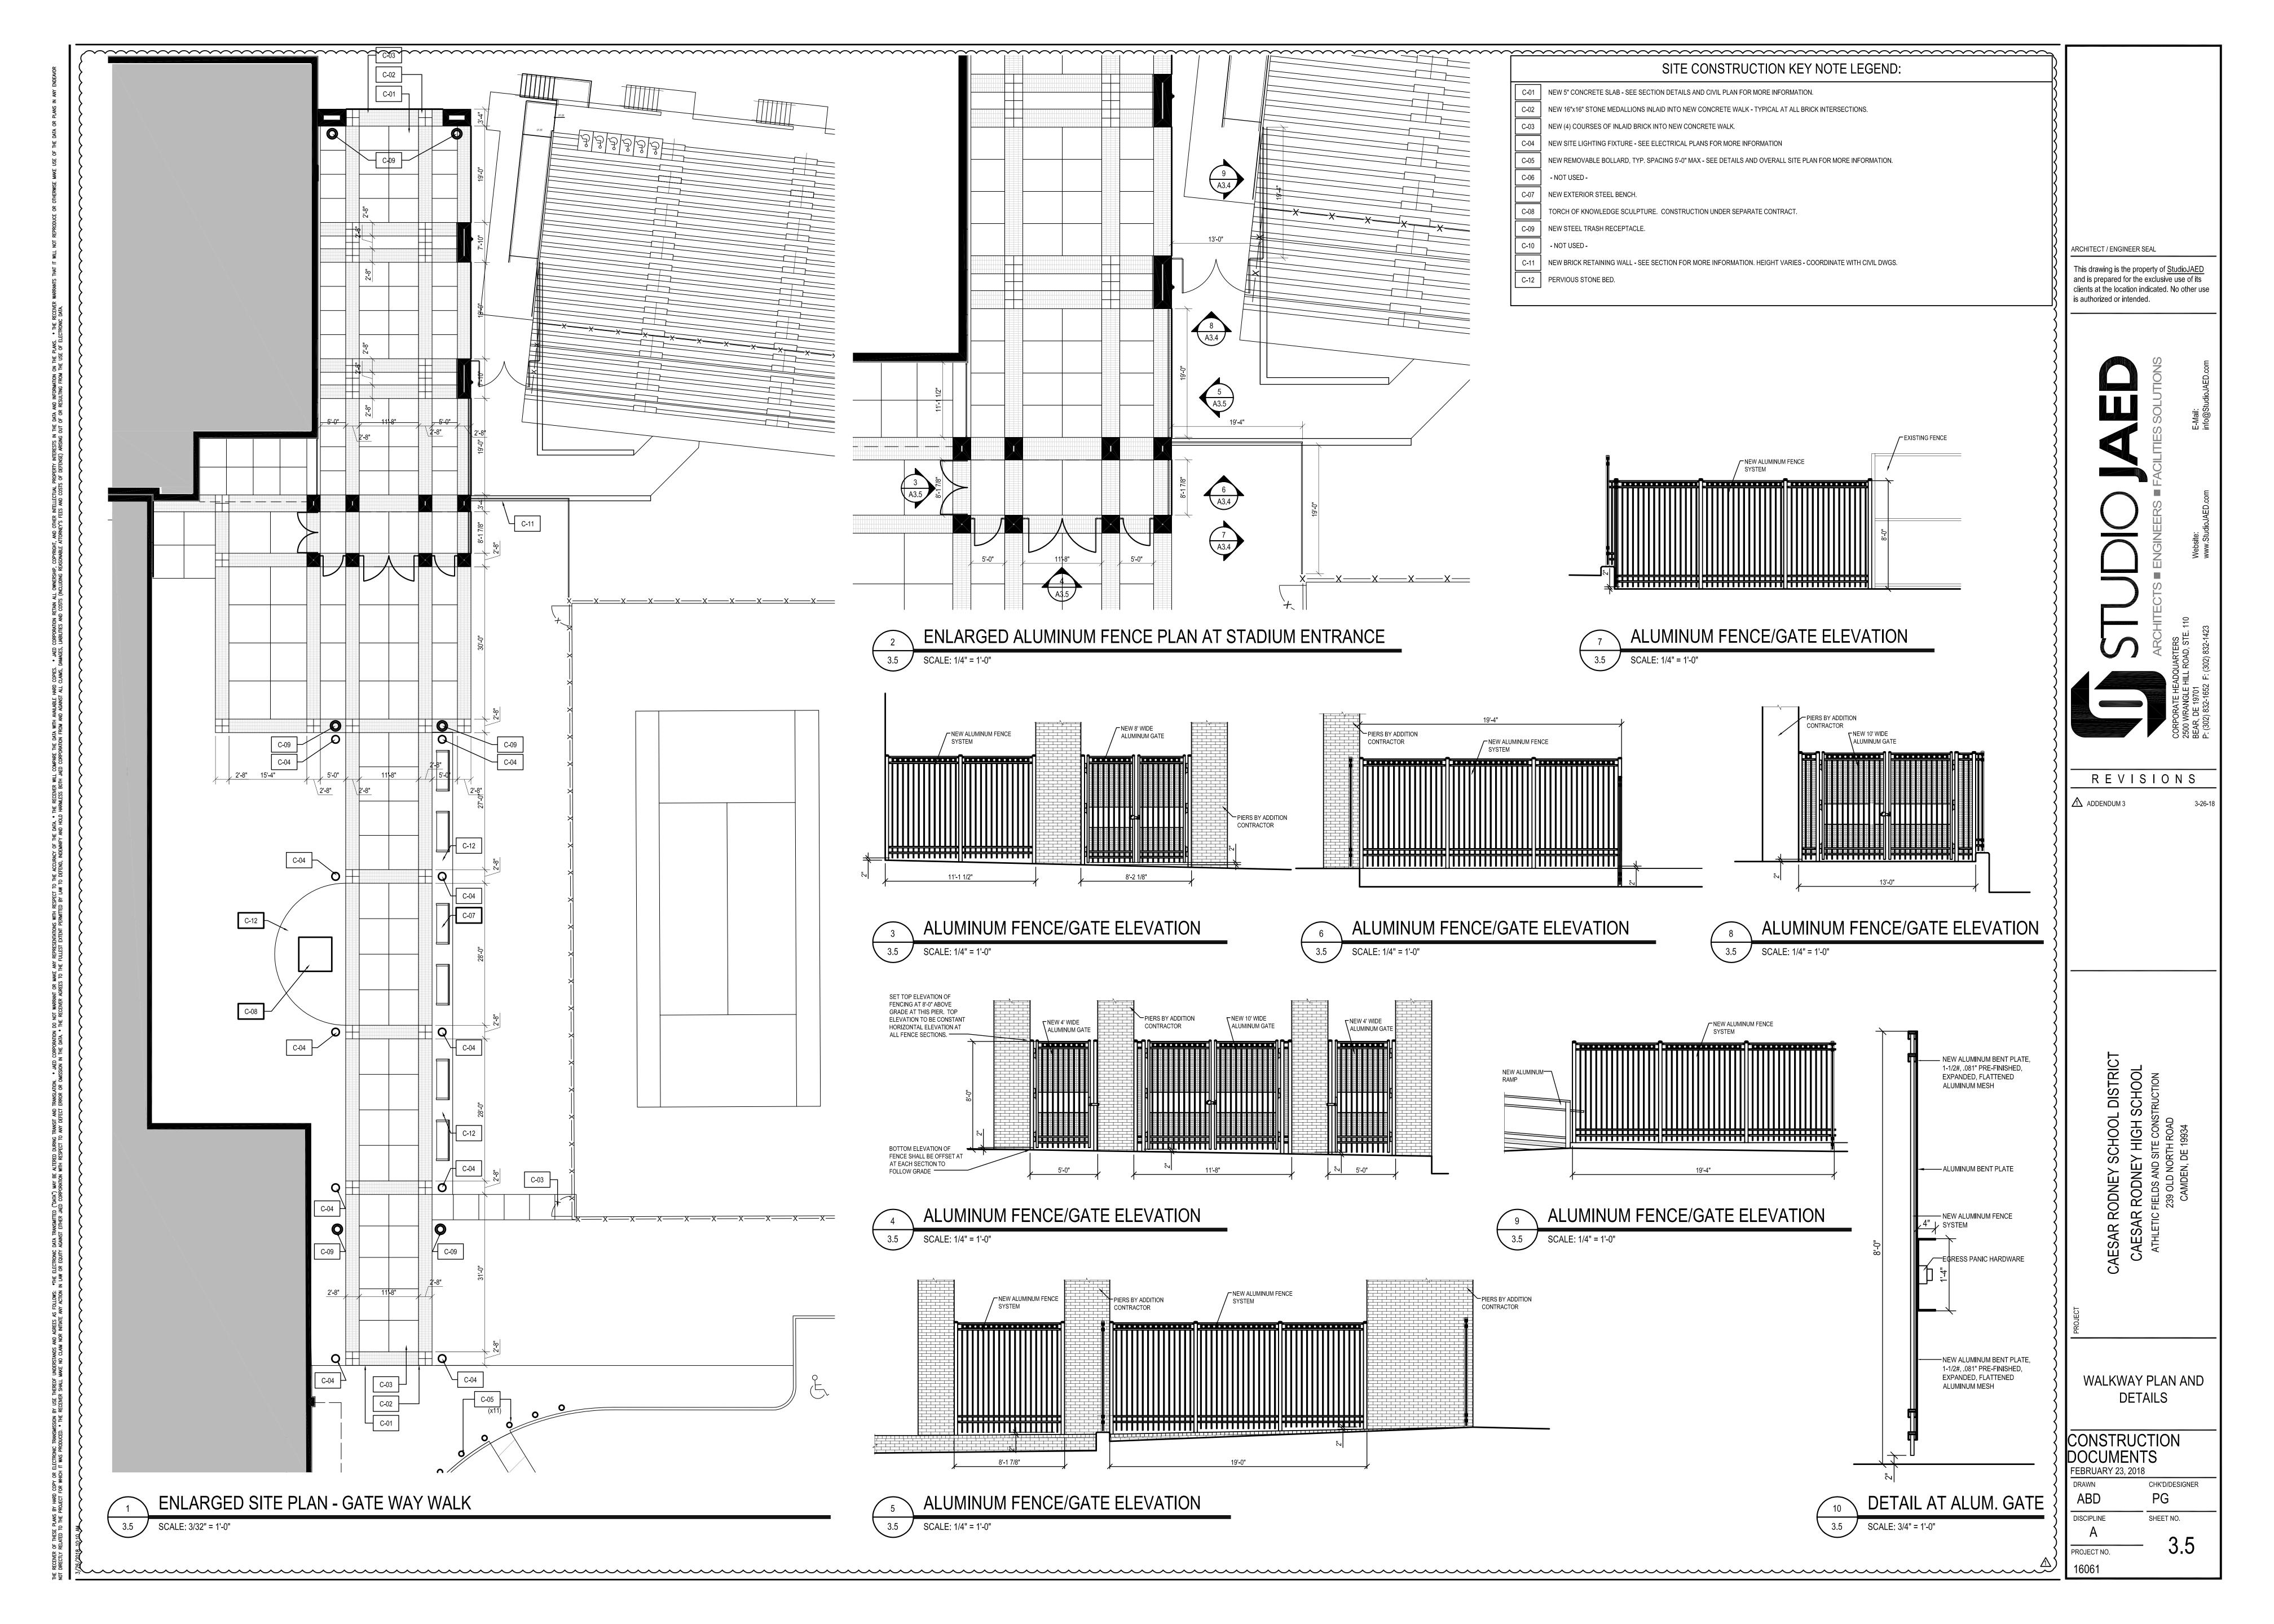

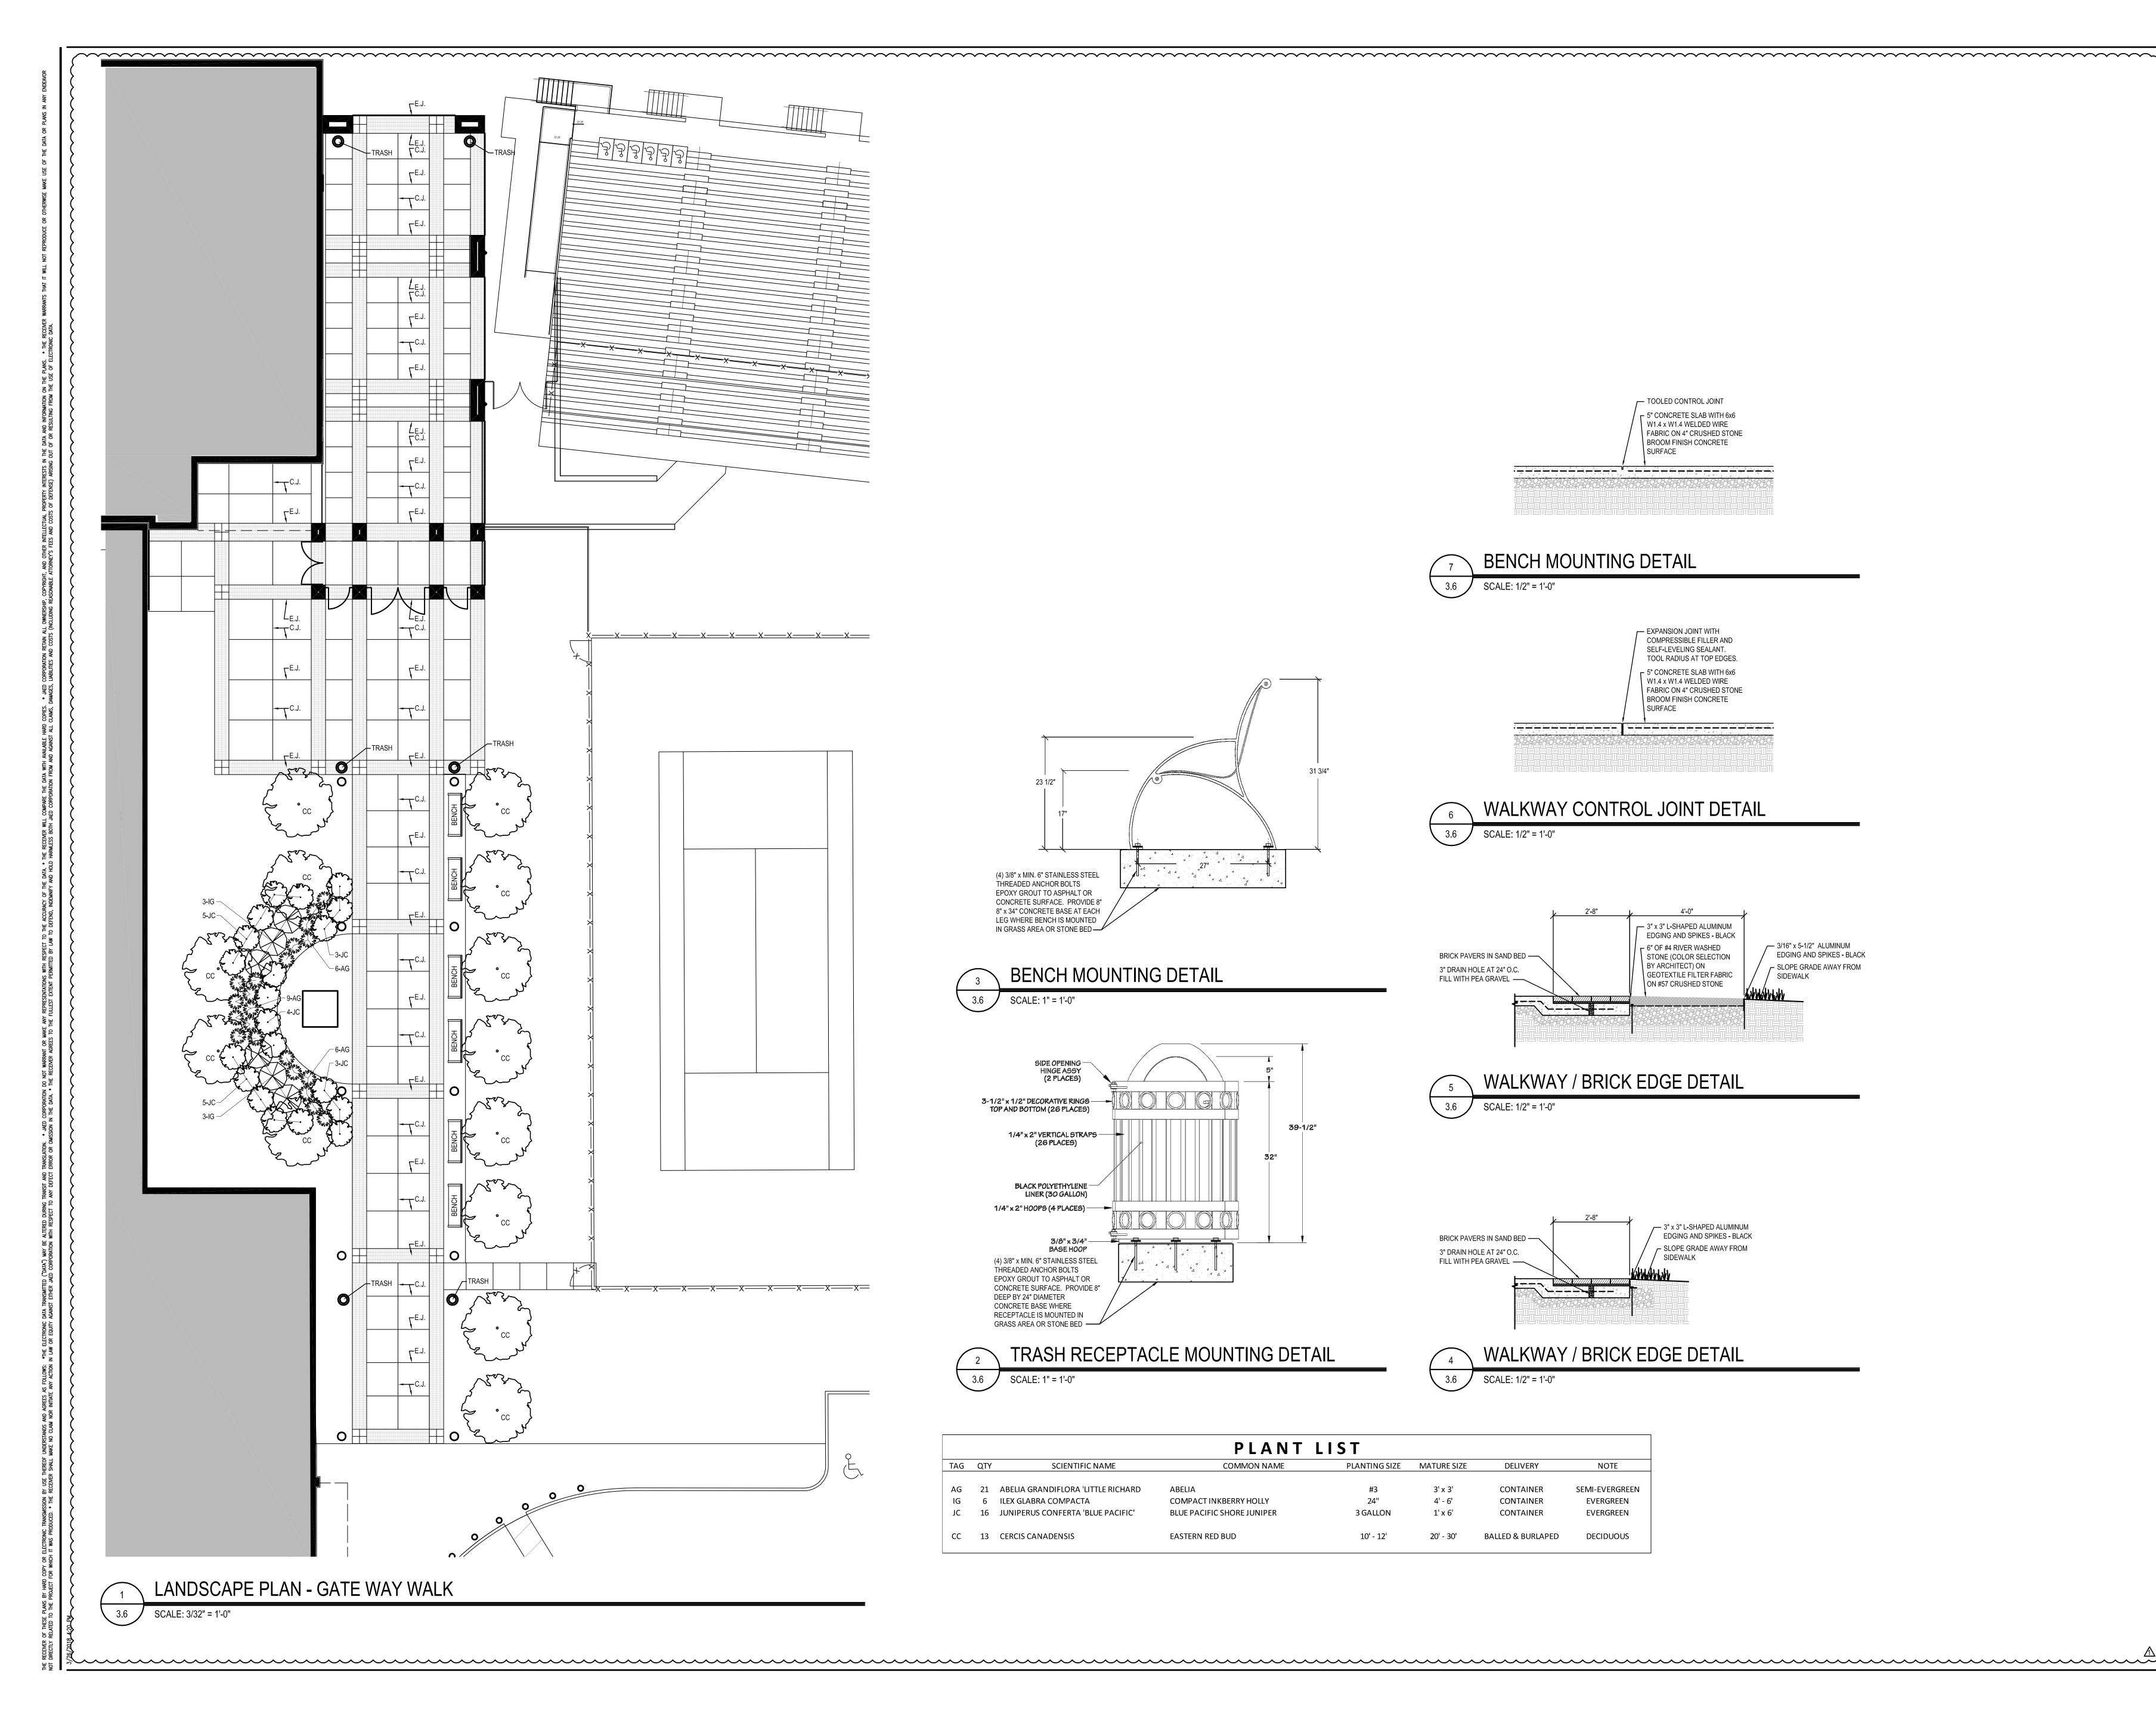

ARCHITECT / ENGINEER SEAL

This drawing is the property of <u>StudioJAED</u> and is prepared for the exclusive use of its clients at the location indicated. No other use

is authorized or intended.

REVISIONS

⚠ ADDENDUM 3

LANDSCAPE PLAN AND

CONSTRUCTION DOCUMENTS CHK'D/DESIGNER DISCIPLINE SHEET NO. PROJECT NO.